CITY OF MILL CREEK DESIGN REVIEW BOARD APPLICATION PL2019-0015

PART I - SUMMARY INFORMATION

NAME OF PROJECT: Brooks Homes

Roadway Buffer Landscaping and Streetscape

APPLICANT: Ed Brooks

Brooks Homes

13724 42nd Avenue Southeast Mill Creek, Washington 98012

LOCATION: The project is located at 2904 Seattle Hill Road

PROPOSAL: Review of the proposed roadway buffer landscaping and streetscape

ZONING AND

COMPREHENSIVE

PLAN DESIGNATION: LDR Low Density Residential

PART II – DESIGN REVIEW BOARD AUTHORITY

Mill Creek Municipal Code (MCMC) Section 17.34.020 states that the Design Review Board shall review, "all streetscape landscaping and monument signs for detached and attached single-family residential, multifamily residential, industrial, and commercial developments." This project was reviewed in accordance with MCMC Chapter 17.34.040.H Landscaping Design.

PART III - BACKGROUND

On November 28, 2018, the Hearing Examiner approved the Preliminary Plat and Planned Residential Development (PRD) known as Three Oaks. As required in the Comprehensive Plan, a 50-foot roadway buffer was required along Seattle Hill Road. As a Condition of Approval for the Preliminary Plat/PRD, the applicant was required to prepare a landscape plan for the private drive (Tract 999) and the roadway buffer (Tracts A and B) and have the landscape plan reviewed and approved by the Design Review Board.

PART IV - PROJECT DESCRIPTION AND ANALYSIS

Roadway Buffer

Some existing vegetation in the roadway buffer will be retained, including six Fir trees, three Maple trees and a mature Rhododendron. The roadway buffer is proposed to be planted with additional trees including Western Red Cedar, Red Sunset Maple, and Vine Maple. Proposed shrubs include Azalea, Sword Fern, Evergreen Huckleberry, Kelsii Dogwood, Lavender and Spirea as well as Salal, which is being used as a groundcover. The plant palette is mostly native and drought tolerant once established.

The City's Comprehensive Plan Streetscape Policies state that landscaping of the roadway buffers can include one or more of the following forms Native Growth, Natural Plantings or Formal Plantings depending on the intended use of the site. The proposed landscape plan most closely fits the definition of Natural Plantings.

Natural Plantings: Includes the retention of suitable existing vegetation (healthy, non-invasive) supplemented with areas of new vegetation selected to complement the existing vegetation, including trees, shrubs, groundcover and sod. The use of native plants is encouraged to achieve a more informal planting scheme. Minor changes to existing topography may be made to achieve a naturalized planting scheme, while avoiding impacts to the driplines of existing significant trees.

It is staff's opinion that the proposed landscape plan is consistent with the City's Comprehensive Plan Policies.

Following is an analysis of the proposed landscape plan with respect to the regulations contained in the MCMC Chapter 17.34.

Mill Creek Municipal Code (MCMC) Section 17.34.040.H - Landscaping Design	
a. Project landscaping shall provide unity of	The proposed plan is consistent with this Code
design through repetition of plants and	requirement.
coordination with adjacent developments.	
b. Landscape materials should be hardy species	The proposed plant palette consists of plant
that are adaptable to local conditions, easily	species that are native, drought tolerant once
maintained, and drought tolerant. Use of native	established, and are relatively low maintenance.
plants and the retention of existing vegetation are	
strongly encouraged.	
d. Landscaped areas shall be irrigated by	Irrigation is proposed.
mechanical sprinkler systems.	

Streetscape

The streetscape consists of a planter strip planted with lawn and street trees. The street tree species proposed is Armstrong Maple. The Armstrong Maple is not on the City's Approved Street Tree list; however, staff researched the Armstrong Maple and found that "Roots raise sidewalks less often than Silver Maples do because of a slower growth rate and less aggressive root system." However, Armstrong Maple can develop surface roots in clay soil. As a result, a Condition of Approval has been added requiring the applicant to prepare the planter strip by amending the soil and using a planting

hole for the street trees that is three times the width of the root ball. The applicant is required to retain the duff layer of topsoil when clearing the site for development and this topsoil could be reused to amend the soil in the planter strip and ensure a good planting bed for the street trees. In addition, the Code requires the use of root barrier to help alleviate future issues with surface roots and potential damage to infrastructure.

PART V - FINDINGS, CONCLUSIONS, AND RECOMMENDATION

Having viewed the property and reviewed the application, City staff finds that as conditioned the proposed Landscape Plan is consistent with the design guidelines set forth in MCMC Section 17.34.040.H. Based on these findings and conclusions, staff recommends approval subject to the following conditions, as well as any conditions that may be added by the Design Review Board.

- 1. The landscaping shall be as portrayed on the materials submitted with the application, except as modified by the conditions imposed by the Design Review Board.
- 2. Revise the landscape plan as follows:
 - Add a note to amend the soil in the planter strip
 - Add note confirming that the existing Fir trees are being retained
 - Show lawn in the planter strip to the south of the ADA crossing ramp
 - Show root barrier adjacent to the street (24 inches) and the sidewalk (18 inches)
 - Adjust spacing on the Salal to 24 inches on center
 - Correct plant quantities
- 3. A landscape performance bond in the amount of 125% of the proposed cost of materials and installation shall be provided to the City prior to installation of the landscaping, pursuant to MCMC Section 16.16.040.
- 4. Irrigation shall be provided for the landscaping, per MCMC Section 17.34.040.H.1.d. The irrigation system will require a building permit. The permit is an over-the-counter plumbing permit, no plans required, with an inspection of the system's backflow prevention.


ATTACHMENTS:


Attachment 1: Vicinity Map

Attachment 2: Proposed Landscape Plan

G:\ELECTRONIC PERMITS - All Depts\Planning\2019\DRB\PL2019-0015 Three Oaks Landscape Plan\staff report.docx

Attachment 1 Vicinity Map

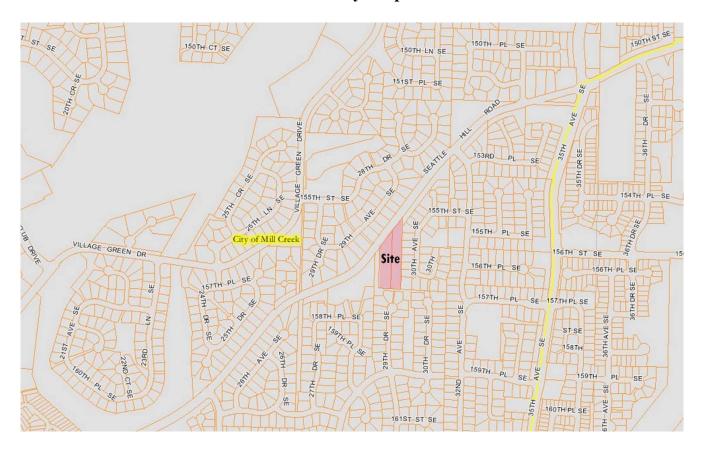

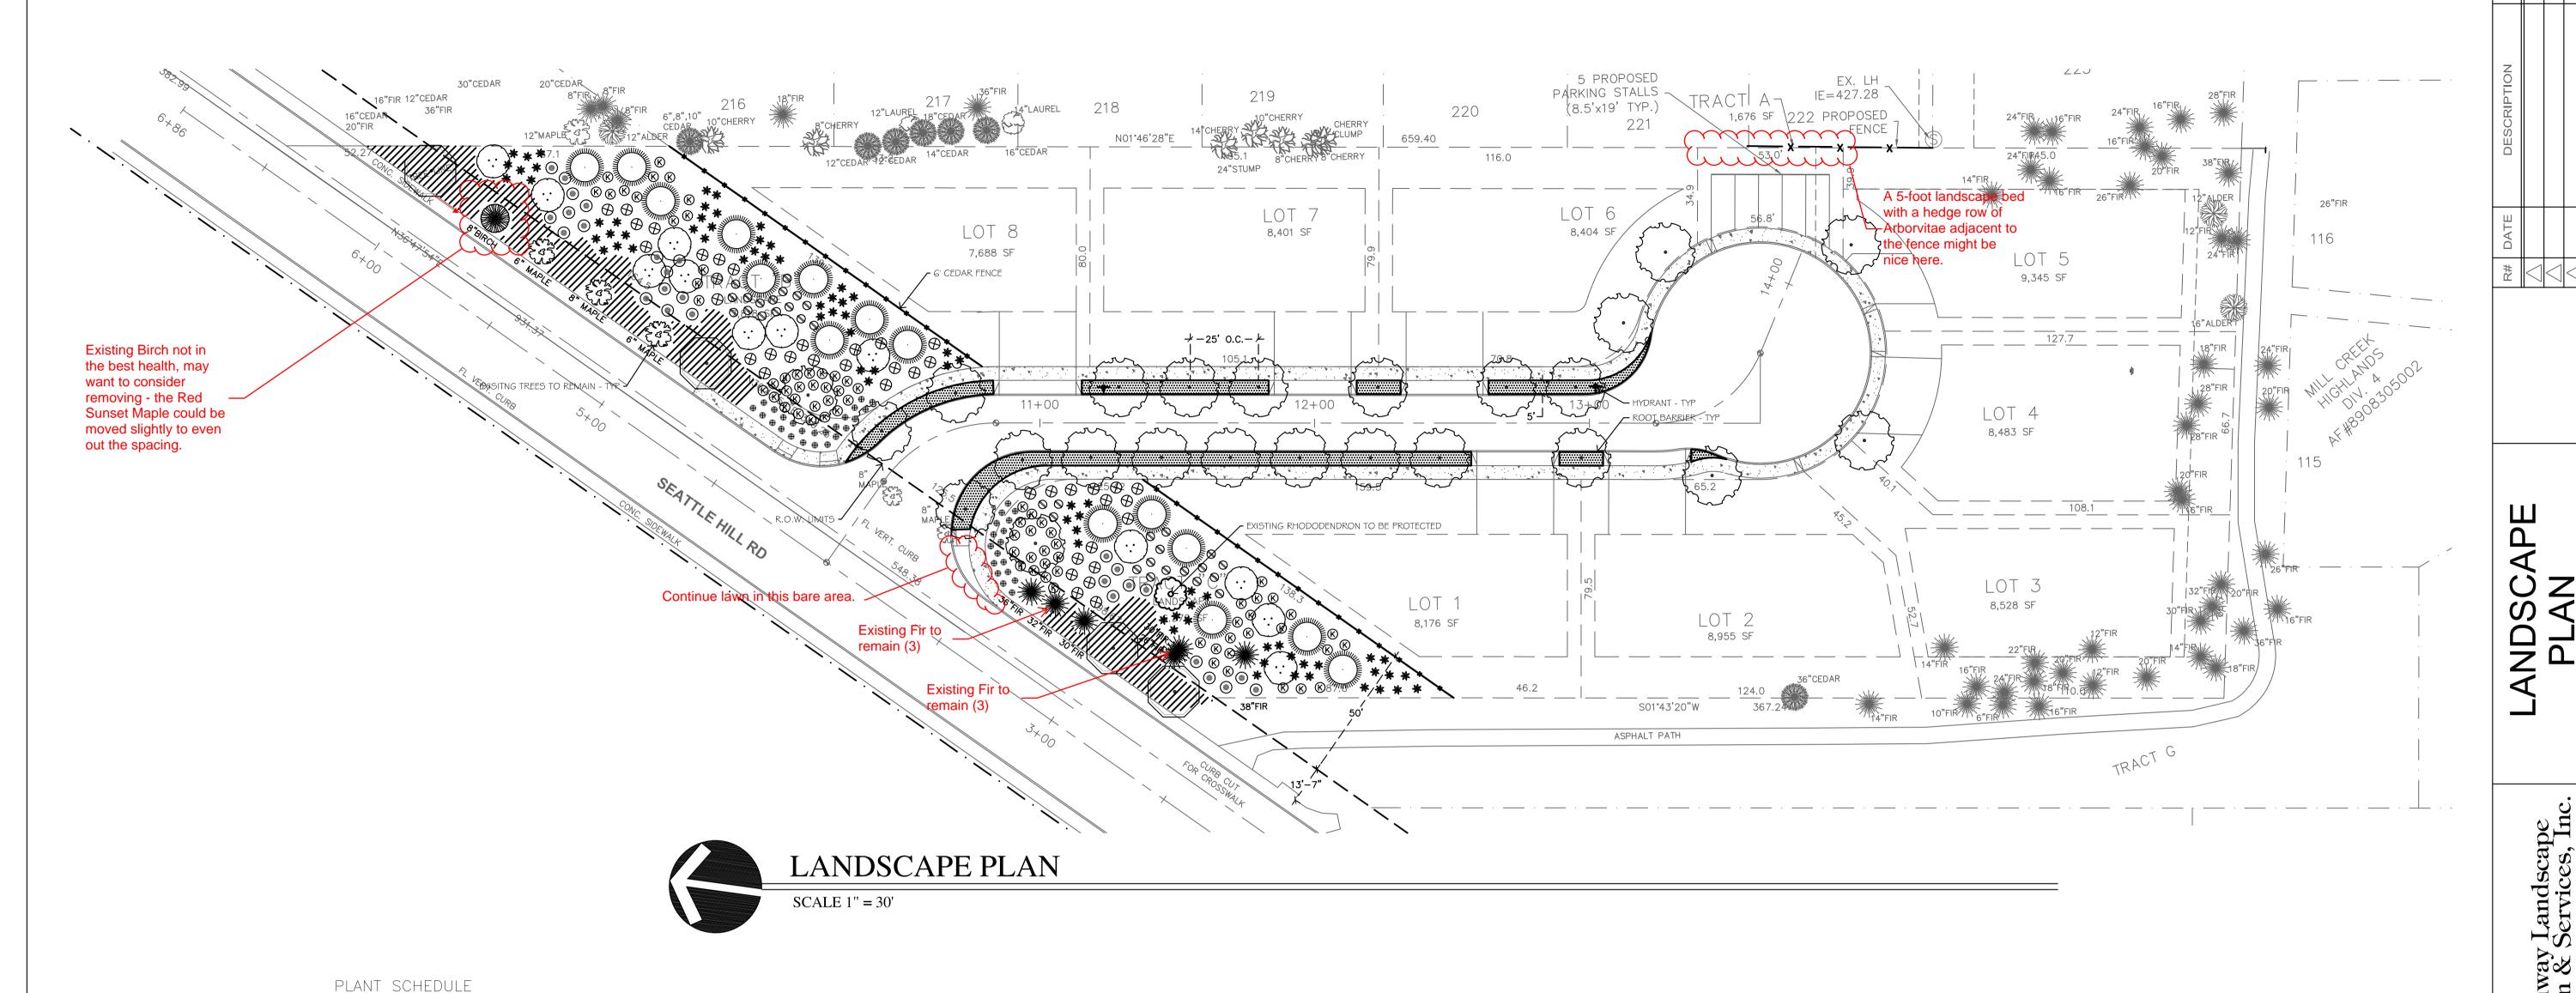

COMMON NAME

9. All tree pits shall be inspected dot ensure proper drainage.

10. Positive drainage shall be maintaned. Mound planting areas minimum 6".


11. Landscape contractor shall maintain site until final inspection and acceptance by

WESTERN RED CEDAR

need adjusting

QTY SIZE # NOTES

15 8'-10' HT., B¢B

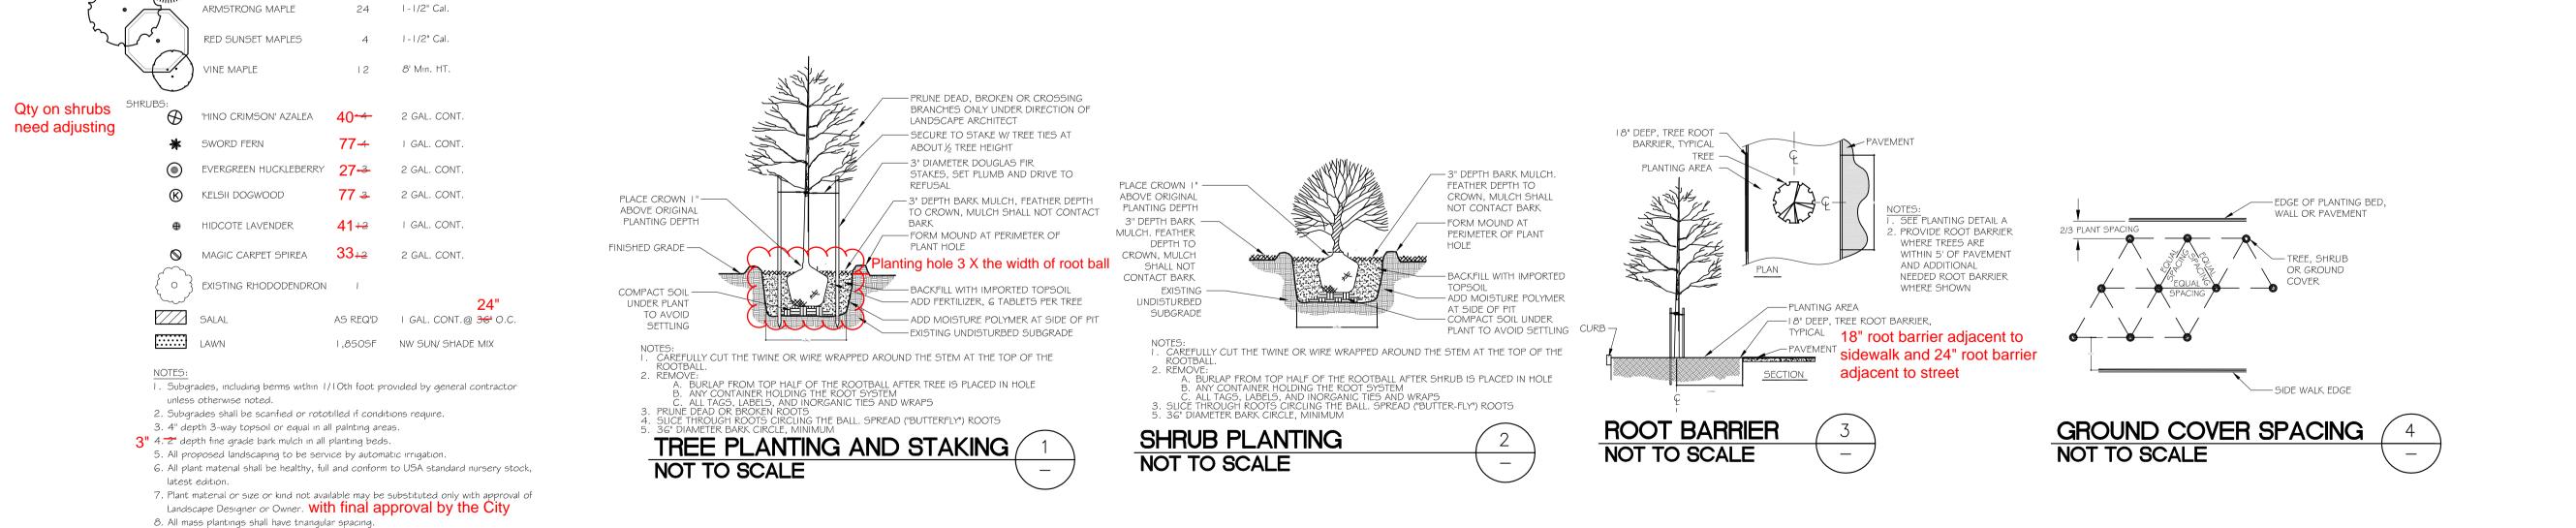

Attachment 2 - Landscape Plan

PROJ. NO.

5/23/2019

1"=30'